



THE STATE
of **ALASKA**
GOVERNOR BILL WALKER

Department of Natural Resources

DIVISION OF OIL AND GAS

550 W. 7th Avenue Suite 1100
Anchorage, Alaska 99501-3560
Main: 907.269.8800
Fax: 907.269.8939

August 30, 2018

Jessika Gonzalez
Permitting Coordinator
ConocoPhillips Alaska, Inc.
PO Box 100360
Anchorage, AK 99501

**RE: LONS 97-007, ConocoPhillips Alaska, Inc., Colville River Unit, CD1, S1 and S2
Module Platforms Unit Plan of Operations Amendment Decision.**

Dear Ms. Gonzalez:

The Alaska Department of Natural Resources, Division of Oil and Gas (Division), in accordance with Alaska Statute 38.05 and Alaska Oil and Gas Leasing Regulations (11 AAC 83) grants authorization to conduct activities on state lands as proposed in the Colville River Unit (CRU) Plan of Operations (Plan) amendment application dated August 20, 2018 for the above referenced project.

Scope:

ConocoPhillips Alaska, Inc. (CPAI) requests authorization to modify the existing S1 and S2 modules by adding a platform adjacent to each of the modules at the Colville Delta 1 (CD1) gravel pad located within the CRU. The existing generators, currently located inside the modules, will be moved to the new platforms outside. The new platforms will each require two vertical support members (VSMs) and three bollards. The VSMs will be installed via the slurry method. The existing stairs will be relocated to accommodate the installation of the new platforms. All project work will occur on the existing pad.

Plan activities include:

- Installation of VSMs measuring approximately 12 inches in diameter to a depth of approximately 40 feet.
- Installation of S1 platform measuring approximately 24 feet long by 16 feet wide.
- Installation of S2 platform measuring approximately 35 feet long by 24 feet wide.
- Relocation of the generators.
- Installation of three bollards.

Location information:

CRU

CD1

Meridian: Umiat

Township: 12N

Range: 5E

Section: 32

Lat: -150.9247887, Long: 70.3449752
ADL(s): 025558

CD1 is located approximately nine miles north of Nuiqsut.

Agency review:

As a courtesy, the amendment application was circulated to the Alaska Department of Fish and Game (ADF&G), and DNR: Division of Mining, Land & Water (DMLW) and Division of Oil and Gas. No comments were received.

Conditions/Stipulations:

1. A certified As-Built survey of the activity shall be provided within one year of placement of the improvement. This As-Built must be both digital and hard copy.

Please attach this amendment approval with the original decision. This unit operations amendment approval is issued in accordance with Alaska Statute 38.05, Alaska Administrative Codes 11 AAC 83.346 and 11 AAC 83.303. The Division reviewed this amendment under the unit regulation for the Plan, 11 AAC 83.346, and considers the factors set forth in 11 AAC 83.303(a) and (b). The amendment was also evaluated against the CRU agreement for conformance.


A person affected by this decision may appeal it, in accordance with 11 AAC 02. Any appeal must be received within 20 calendar days after issuance of the decision, as defined in 11 AAC 02.040(c) and (d) and may be mailed or delivered to the Commissioner, Department of Natural Resources, 550 W 7th Avenue, Suite 1400, Anchorage, Alaska 99501; faxed to 1-907-269-8918, or sent by electronic mail to dnr.appeals@alaska.gov. This decision takes effect immediately. If no appeal is filed by the appeal deadline, this decision becomes a final administrative order and decision of the department on the 31st day after issuance. An eligible person must first appeal this decision in accordance with 11 AAC 02 before appealing this decision to Superior Court. A copy of 11 AAC 02 may be obtained from any regional information office of the Department of Natural Resources.

This approval signifies only that the State of Alaska has no objection to the operations outlined in the Plan amendment application. It does not constitute certification of any property right or land status claimed by the applicant nor does it relieve the applicant of responsibility to obtain approvals or permits from other persons or governmental agencies that may also be required. All stipulations contained in the original lease and subsequent Plan approvals remain in full force and effect.

If activities have not commenced, this approval expires on August 30, 2021. Failure to comply with the terms and conditions outlined in the lease, the attached stipulations, and this authorization may result in revocation of this unit operations approval.

Any questions or concerns about this amendment may be directed to Natural Resource Specialist James Hyun at 907-269-8885 or emailed to james.hyun@alaska.gov.

Sincerely,

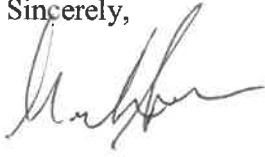

For Nathaniel Emery
Natural Resource Specialist

Attachments: Figures 1-4
2018 North Slope Mitigation Measures

ecc: DOG: Graham Smith, Nathaniel Emery, Paul Blanche, and Mark Henspeter
DMLW: Becky Baird, Henry Brooks, Melissa Head, and Kimberley Maher
ADF&G: Jack Winters
ADEC: Laurie Silfven


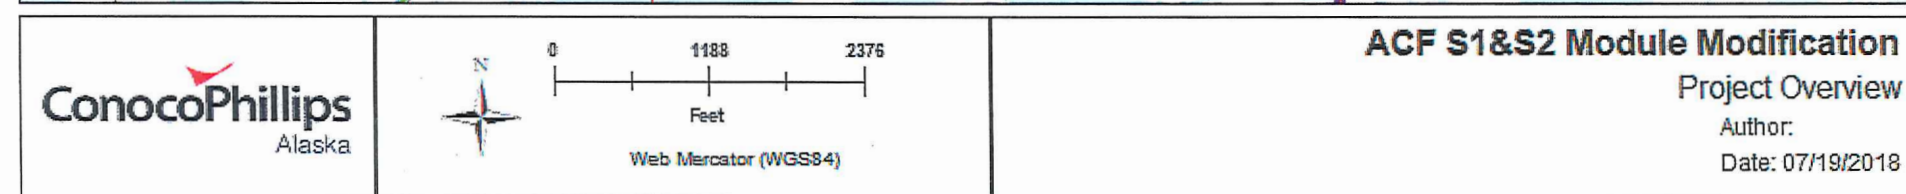


Figure 1

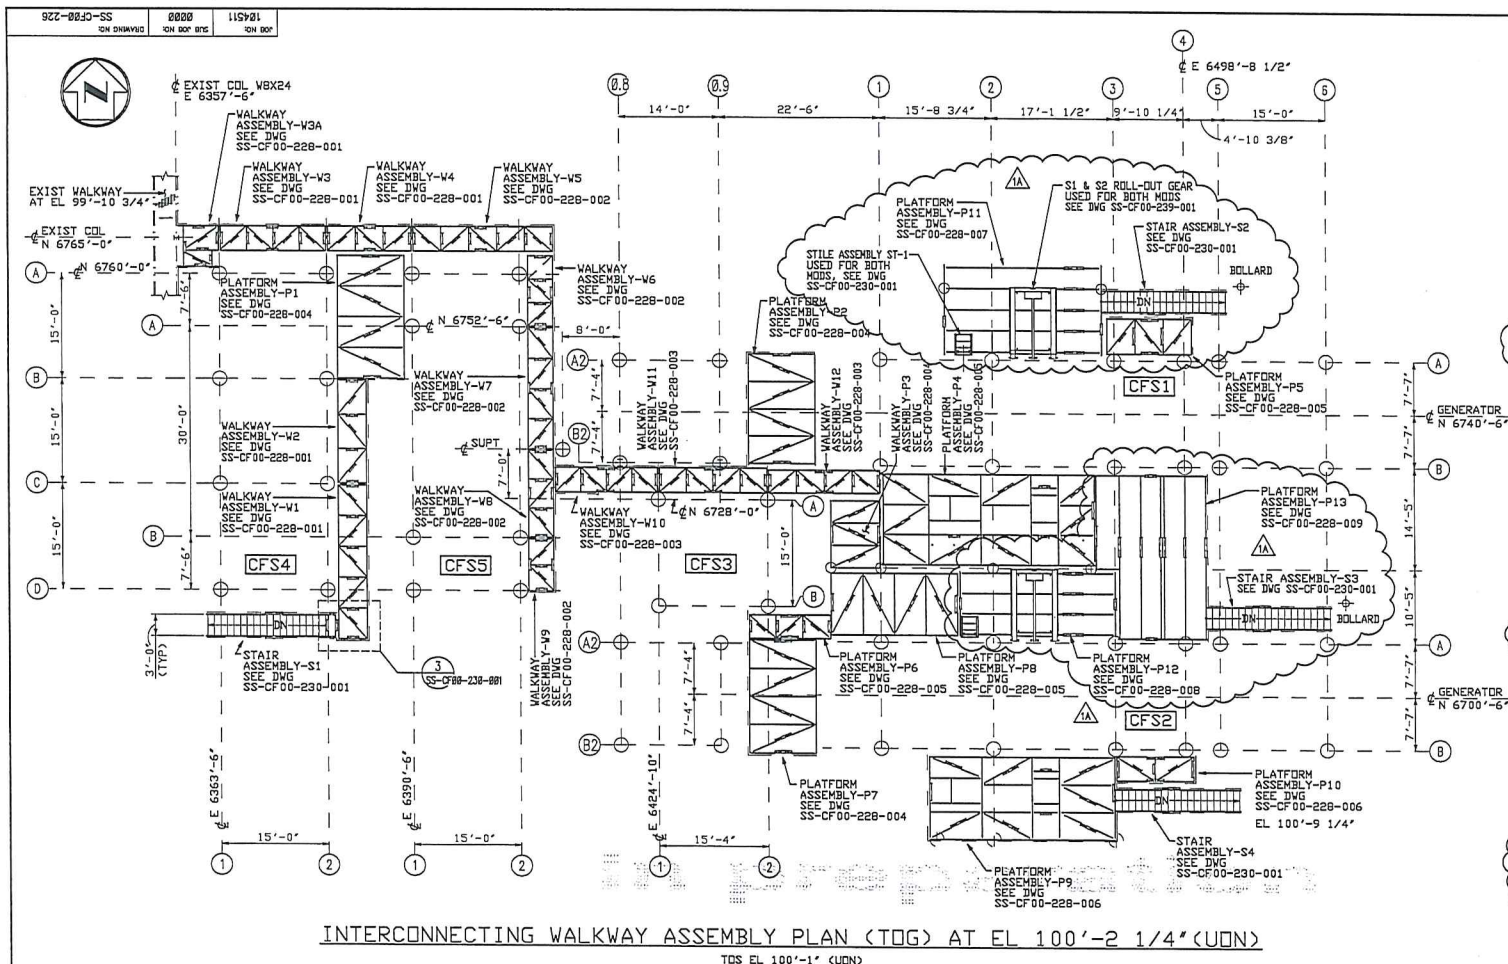

DRAWING INDEX	
DRAWING NUMBER	DRAWING TITLE
SS-CF00-115-001	KEY PLAN
SS-CF00-226-001	ASSEMBLY GENERAL PLAN
SS-CF00-227-001	SUPPORT FRAMING PLAN
SS-CF00-227-002	SUPPORT FRAMING PLAN
SS-CF00-228-001	ASSEMBLY PLANS
SS-CF00-228-002	ASSEMBLY PLANS
SS-CF00-228-003	ASSEMBLY PLANS
SS-CF00-228-004	ASSEMBLY PLANS
SS-CF00-228-005	ASSEMBLY PLANS
SS-CF00-228-006	ASSEMBLY PLANS
SS-CF00-228-007	ASSEMBLY PLANS
SS-CF00-228-008	ASSEMBLY PLANS
SS-CF00-228-009	ASSEMBLY PLANS
SS-CF00-229-001	ELEVATIONS, SECTIONS AND DETAILS
SS-CF00-229-002	ELEVATIONS, SECTIONS AND DETAILS
SS-CF00-229-003	ELEVATIONS, SECTIONS AND DETAILS
SS-CF00-229-004	ELEVATIONS, SECTIONS AND DETAILS
SS-CF00-229-005	ELEVATIONS, SECTIONS AND DETAILS
SS-CF00-229-006	ELEVATIONS, SECTIONS AND DETAILS
SS-CF00-229-007	ELEVATIONS, SECTIONS AND DETAILS
SS-CF00-229-008	ELEVATIONS, SECTIONS AND DETAILS
SS-CF00-229-009	ELEVATIONS, SECTIONS AND DETAILS
SS-CF00-229-010	ELEVATIONS, SECTIONS AND DETAILS
SS-CF00-230-001	STAIR DETAILS
SS-CF00-231-001	ASSEMBLY DETAILS
SS-CF00-239-001	ROLL-OUT GEAR PLANS, SECTIONS & DETAILS

- NOTES:**
- FOR NOTES AND KEY PLAN SEE DRAWING SS-CF00-115-001.
 - FOR WALKWAY ASSEMBLY SUPPORT FRAMING PLAN SEE DRAWING SS-CF00-227-001.
 - FOR PIPE/CABLE TRAY SUPPORT FRAMING PLAN SEE DRAWING SS-CF00-227-002.
 - ALL GRID LINE DIMENSIONS SHOWN ON THIS DRAWING ARE FOR REFERENCE ONLY. FOR ACTUAL GRID LINE DIMENSIONS SEE DRAWING SS-CF00-506-001.
 - ALL STEEL SHALL BE TYPE (V) UNLESS OTHERWISE NOTED.
 - MATERIALS FOR STIFFENERS, GUSSETS, CONNECTION PLATES, CAP AND BASE PLATES SHALL BE A572 GRADE 50.
 - STRUCTURAL STEEL WIDE FLANGE SHAPES SHALL CONFORM TO ASTM A992, GRADE 50, SEE BDM AND/OR DRAWINGS FOR SHAPES REQUIRING LOW TEMPERATURE (LT) STEEL.
 - STRUCTURAL STEEL CHANNELS & ANGLES SHALL CONFORM TO ASTM A36 WITH FY=36 KSI MINIMUM YIELD.
 - ALL PLATE 3/8" THICK AND LARGER SHALL CONFORM TO ASTM A572 GR 50, LOW TEMPERATURE (LT) STEEL UNQ.
 - ALL STRUCTURAL TUBE (HSS) SHALL CONFORM TO ASTM A500, GRADE C, FY=46 KSI MIN YIELD.

LEGEND:

W1 DENOTES WALKWAY ASSEMBLY
P1 DENOTES PLATFORM ASSEMBLY
S1 DENOTES STAIR ASSEMBLY

ConocoPhillips
Alaska, Inc.

ALPINE MODULE: CF00 UNIT: CF

CF00
ASSEMBLY GENERAL PLAN
INTERCONNECTING WALKWAY

REVISION FROM: 1 2 3 4 5 6 7 8 9 10

DO NOT SCALE ABOVE SCALE FOR REFERENCE ONLY


DATE: 1/26/84 DRAWN: AE DESIGN: DF ECH NO: 22221155XX

SCALE: 1/8"=1'-0" CHECKER: HE/WH CD NO: APPROVAL: LWJ/AH CADD FILE NO: JOB NO: 104511 SUB JOB NO: 0000 DRAWING NO: SS-CF00-226 PART: 001 OF 1A REV: 1A

REFERENCE DWG NO./SHEET NO.				SS-CF00-115				001				KEY PLAN																																																																																																																																																																																																																																																																																																																																																																																																																																																																																																																																																																																																																																																																																																																																																																																																																																																																																																																																																																																																																																																																																																																																																																																																																																																																																																																																																																																																																																																																																																																																																																																																																																																																																																																																																																																																																																																																																																																																																																																																																																																																																																																																																																																																																																																																																																																																																																																																																																																																																																																																																																																																																											
-----------------------------	--	--	--	-------------	--	--	--	-----	--	--	--	----------	--	--	
YA/SSCF00226 001 AD 22114802ACS PR JIMILLE27 2018-02-25T15:52:09

Figure 2

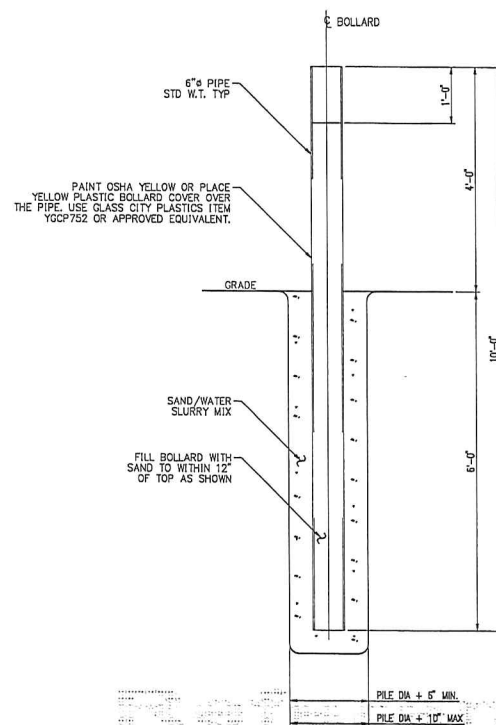

1 TYPICAL BOLLARD DETAIL
SCALE: 1"=1'-0"

REFERENCE DWG FOR
ECM 22114802ACS

ConocoPhillips Alaska, Inc.	
AREA: XX	MODULE: XXXX UNIT: X
KUPARUK RIVER UNIT BOLLARD DETAIL	
REDRAWN FROM:	CONSTRUCTION SHEET OF
DO NOT SCALE	
DATE: 02/01/09	DESIGN: J. DSCHAAK
SCALE: 1"=1'-0"	ECM NO: 0000
APPROVAL:	CADD FILE NO.
JOB NO: NSDK	SUB JOB NO: 0000
DRAWING NO: STD-SS-NS-40185	PAGE: 001 of 1

REFERENCE DWG NO./SHEET NO.

REV	DATE	REVISIONS	BY	CHK	APP	REV	DATE	REVISIONS	BY	CHK	APP
1	02/09	DRAWN PER K090010ACS	JHD								

Figure 4